


Map 3:- Existing boundary with new boundary superimposed



Red line- new boundary
Black line:- existing boundary

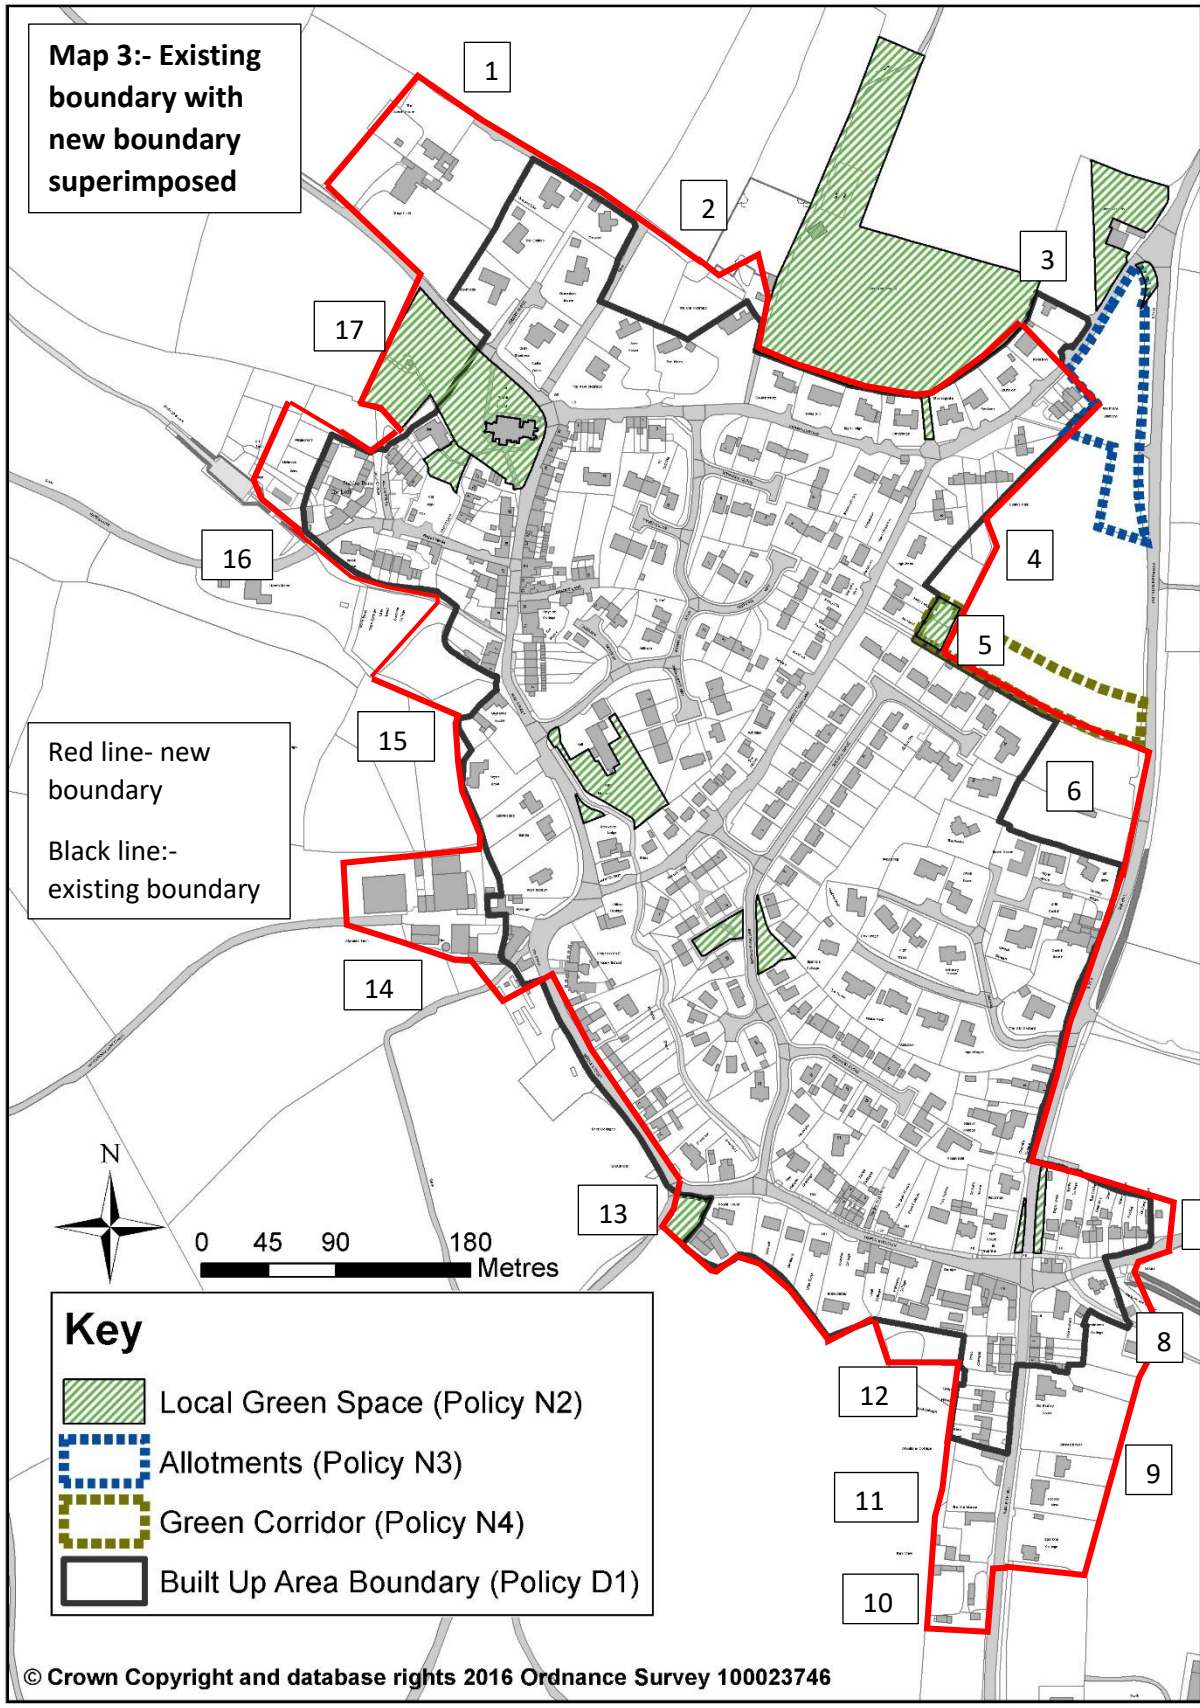

0 45 90 180 Metres

Key

- Local Green Space (Policy N2)
- Allotments (Policy N3)
- Green Corridor (Policy N4)
- Built Up Area Boundary (Policy D1)